



Genesis L.L.C.

church planners • architectural • civil • project management
2560 Farmer Road, N.W., Conyers Georgia 30013
770.483.8122


THIS DRAWING IS THE PROPERTY OF GENESIS L.L.C. AND IS NOT TO BE REPRODUCED OR TRANSMITTED IN ANY FORM OR BY ANY MEANS, ELECTRONIC OR MECHANICAL, INCLUDING PHOTOCOPYING, RECORDING, OR BY ANY INFORMATION STORAGE AND RETRIEVAL SYSTEM, WITHOUT THE WRITTEN PERMISSION OF GENESIS L.L.C.

H.D.V. 48 MAIN, L.L.C.
48 MAIN STREET SENOIA, GEORGIA
770-599-4000

ISSUE DATE/REVISIONS
20 SEPT. 2007 / REVISIONS
1 JULY 2008 / REVIEW
25 JULY 2008 / PERMIT
21 APRIL 2009 / AS-BUILT

Project name
**H.D.V. 48
MAIN L.L.C.**
48 Main Street
Senora, Georgia
Sheet Title

**THIRD
LEVEL PLAN**
DATE: 09-27-07
SHEET NO. 1/1
FOR CONSTRUCTION

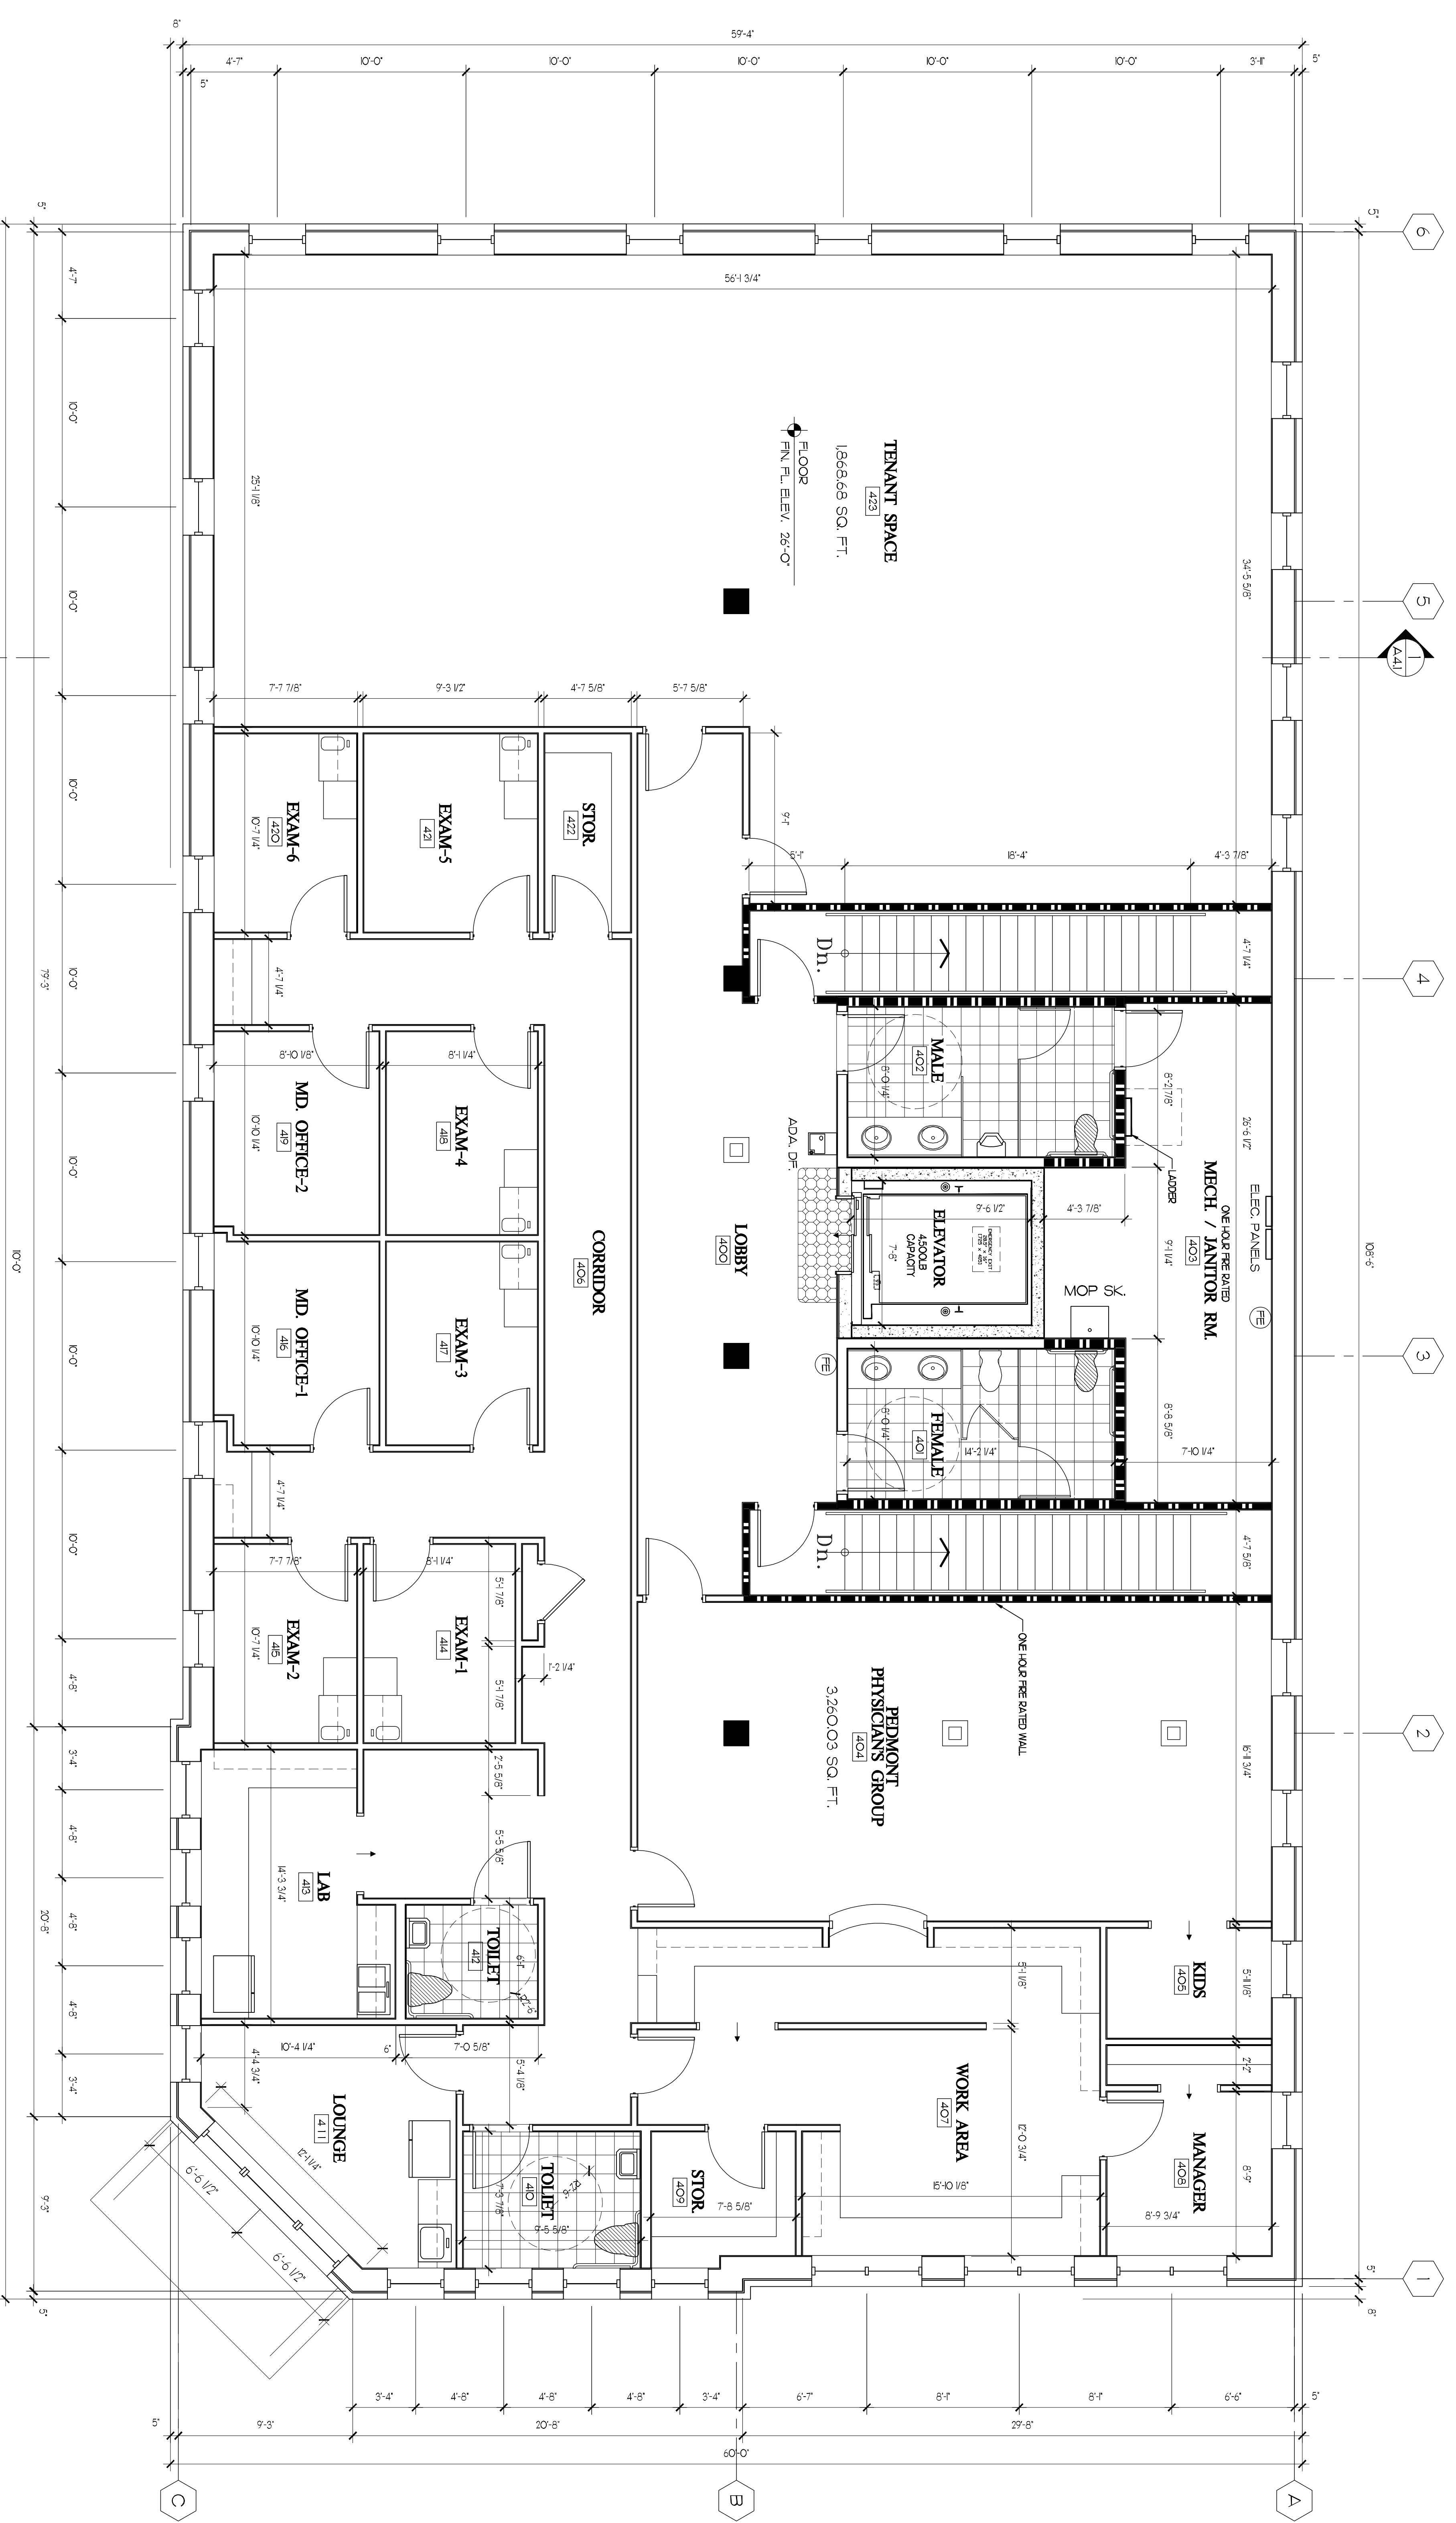

THIRD LEVEL - FLOOR PLAN



1

SCALE 1/4" = 1'-0"

6,266.55 SQ. FT.

GENERAL NOTES:

1. SEE ALL PLAN SHEETS FOR GENERAL NOTES AND SPECIFICATIONS.
2. ALL WORK SHALL BE IN ACCORDANCE WITH THE 2007 INTERNATIONAL BUILDING CODE (IBC) AND ALL APPLICABLE LOCAL, STATE AND FEDERAL CODES.
3. ALL WORK SHALL BE IN ACCORDANCE WITH THE 2007 INTERNATIONAL MECHANICAL AND ELECTRICAL CODE (IMC) AND ALL APPLICABLE LOCAL, STATE AND FEDERAL CODES.
4. ALL WORK SHALL BE IN ACCORDANCE WITH THE 2007 INTERNATIONAL PLUMBING AND MECHANICAL CODE (IPC) AND ALL APPLICABLE LOCAL, STATE AND FEDERAL CODES.
5. THE BUILDING SHALL BE SPRINKLERED.